
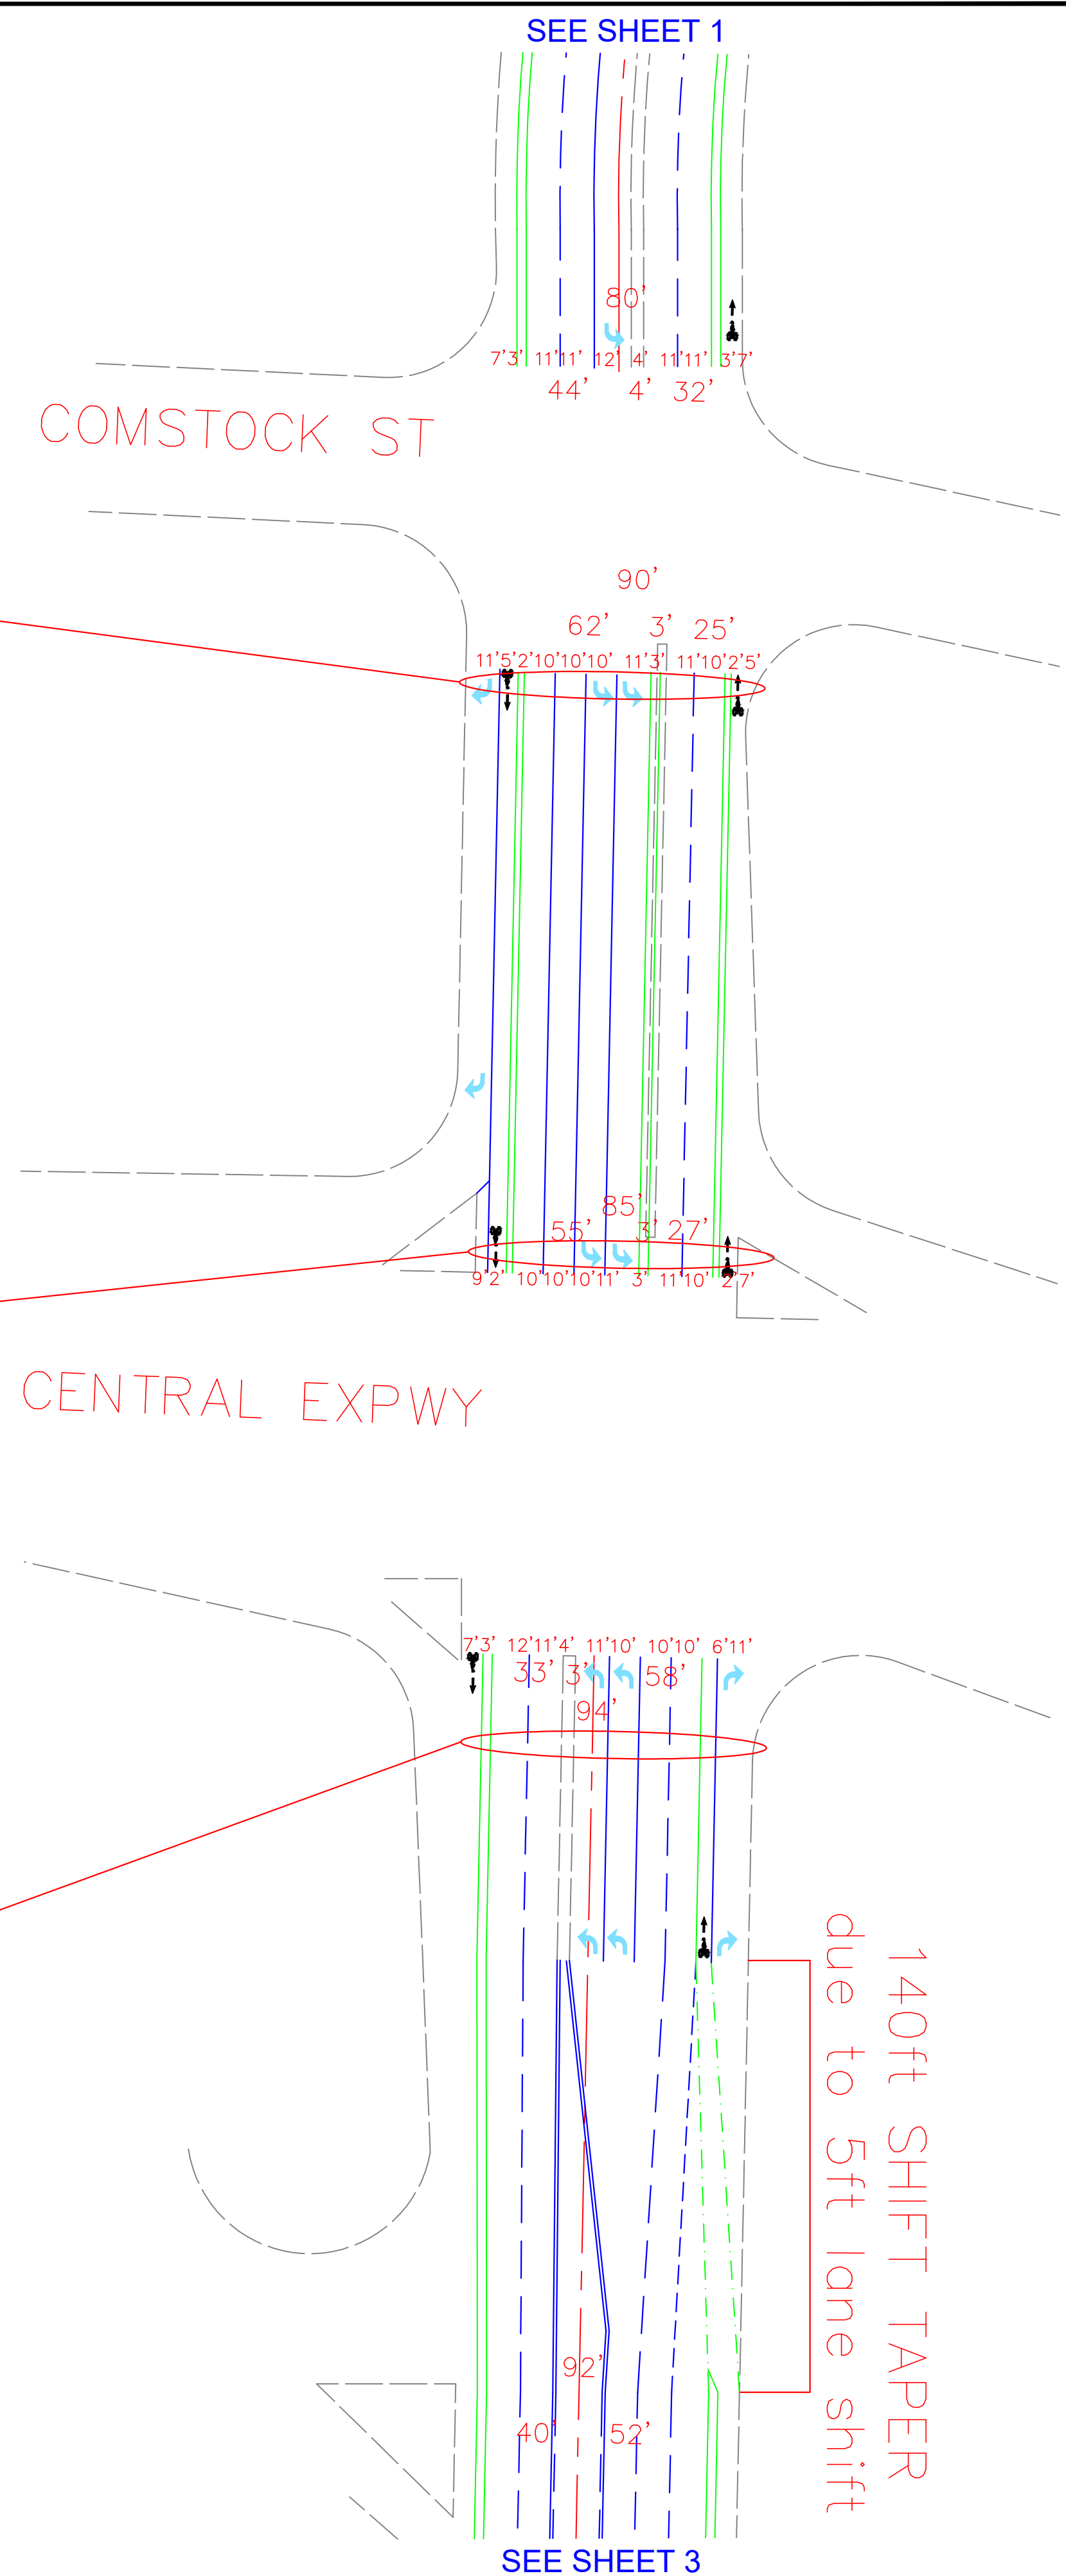
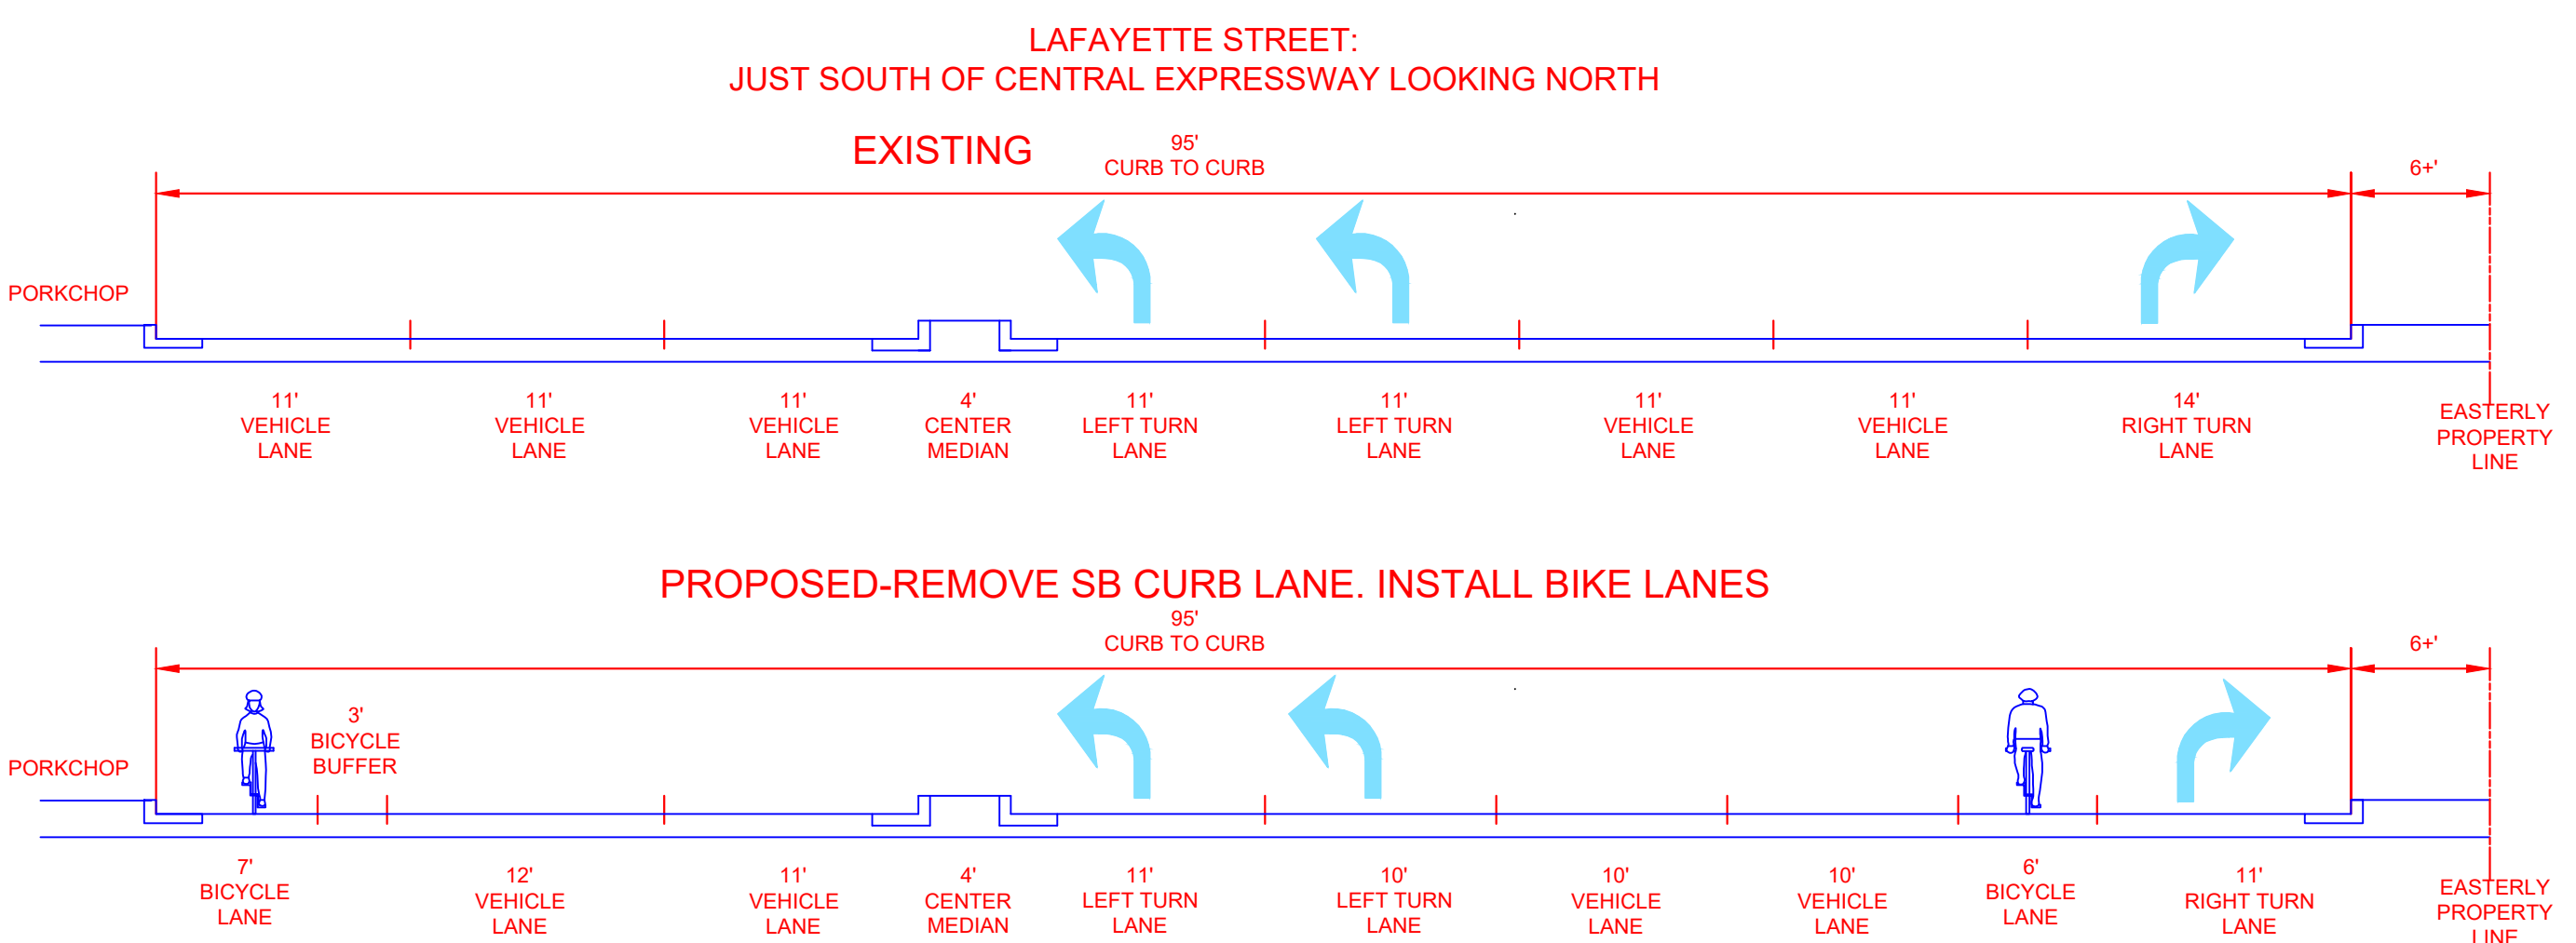
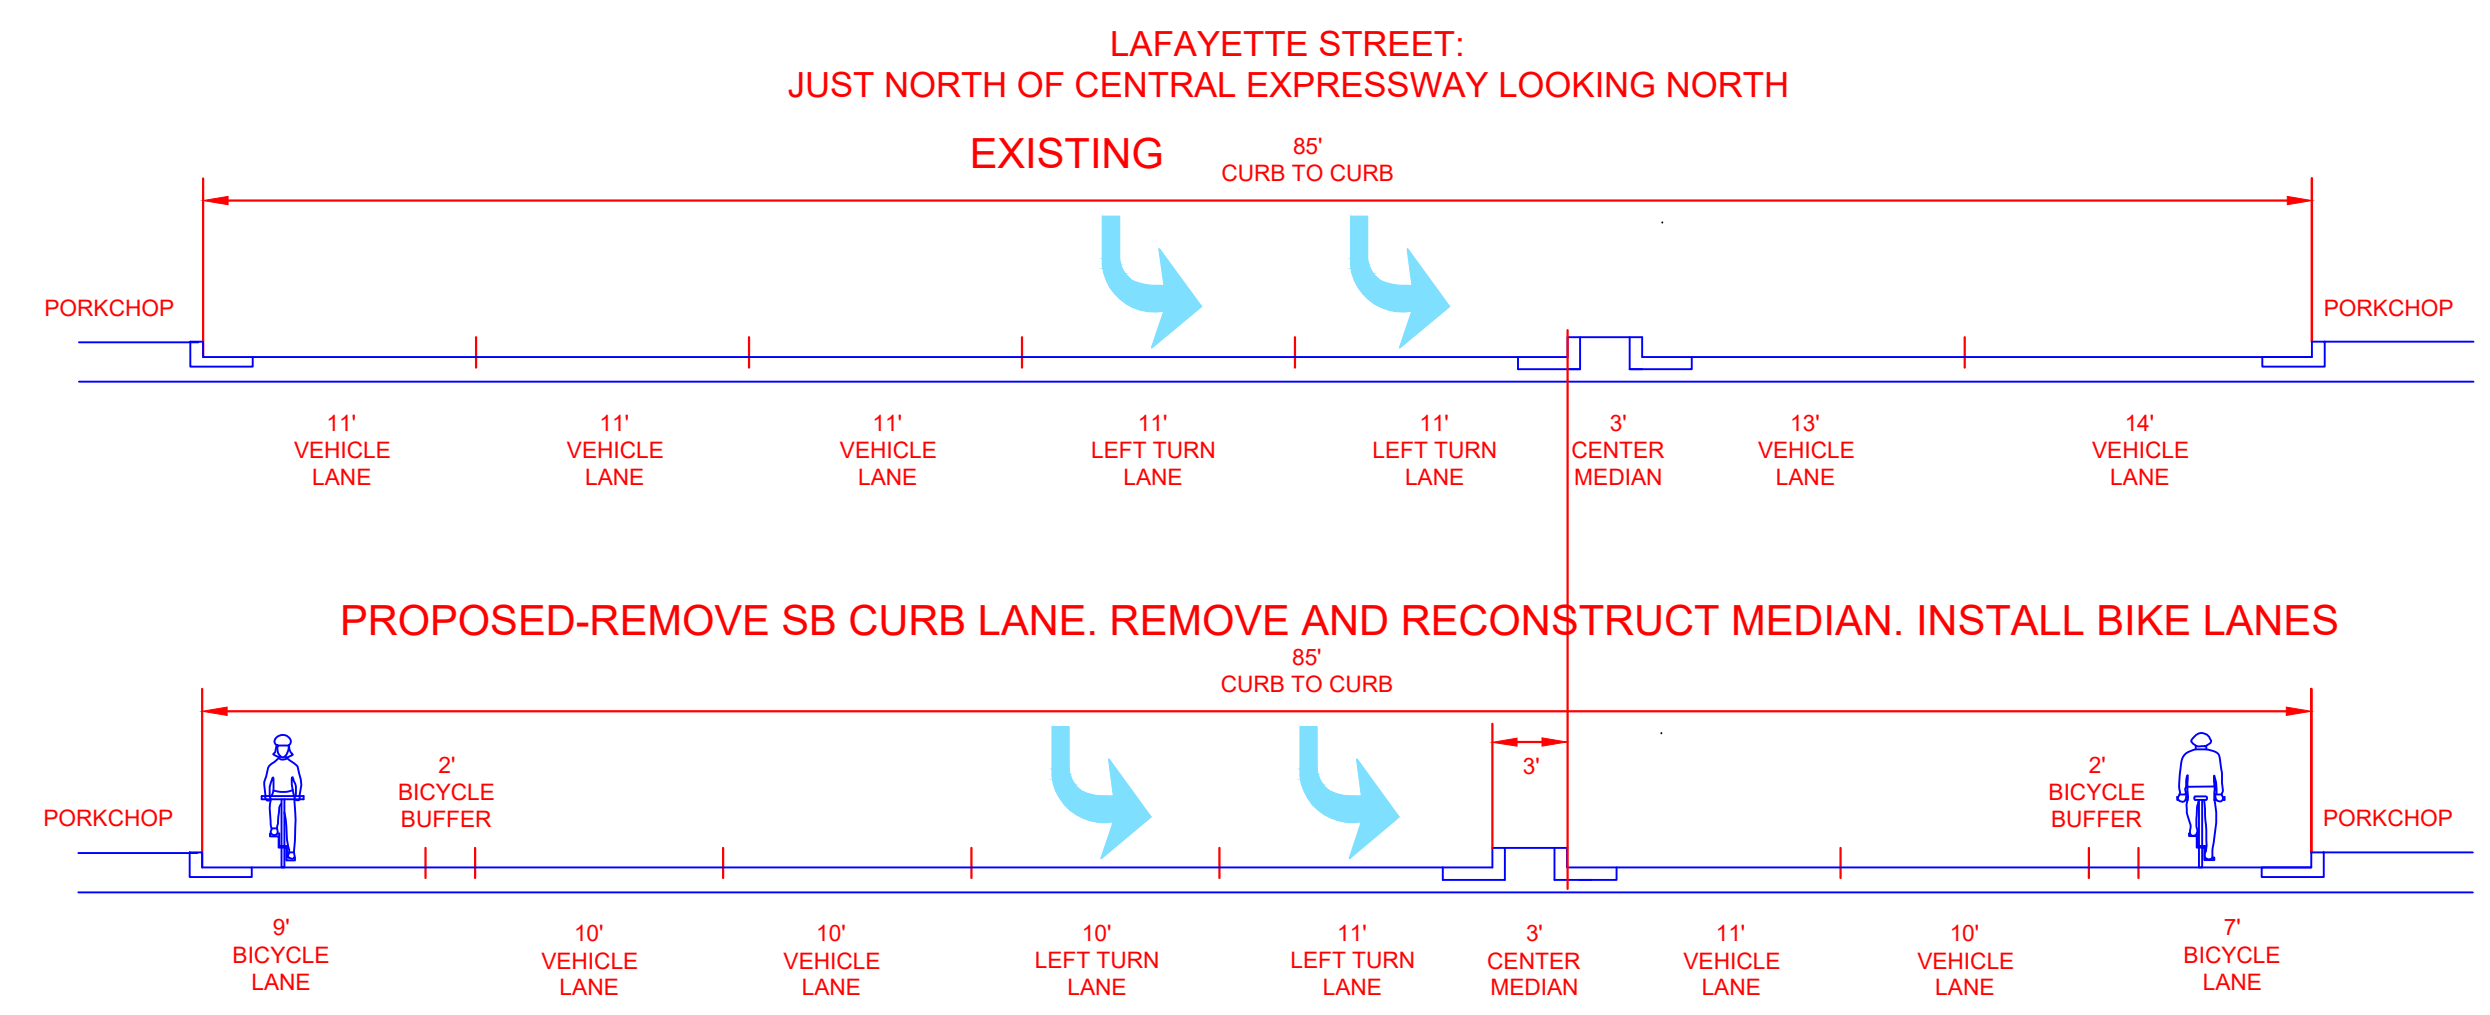


**35% PLANS
NOT FOR CONSTRUCTION**

PROJECT No. CE 02-XX-XX				CITY OF SANTA CLARA ENGINEERING DEPARTMENT				APPROVED BY							
ACCOUNT No. XXX-4443-8030-XXXX								TITLE							
DATE	No.	REVISION	BY	PROJECT TITLE				DATE	R.C.E. No.						
								DESIGNED BY	INITIAL	DATE	Survey No.				
								SHEET TITLE				XX	XX/02	TRACING No.	
												DRAWN BY		11,XXX-D	
												CHECKED BY			
				AS BUILT BY				SHEET 1 OF 5							

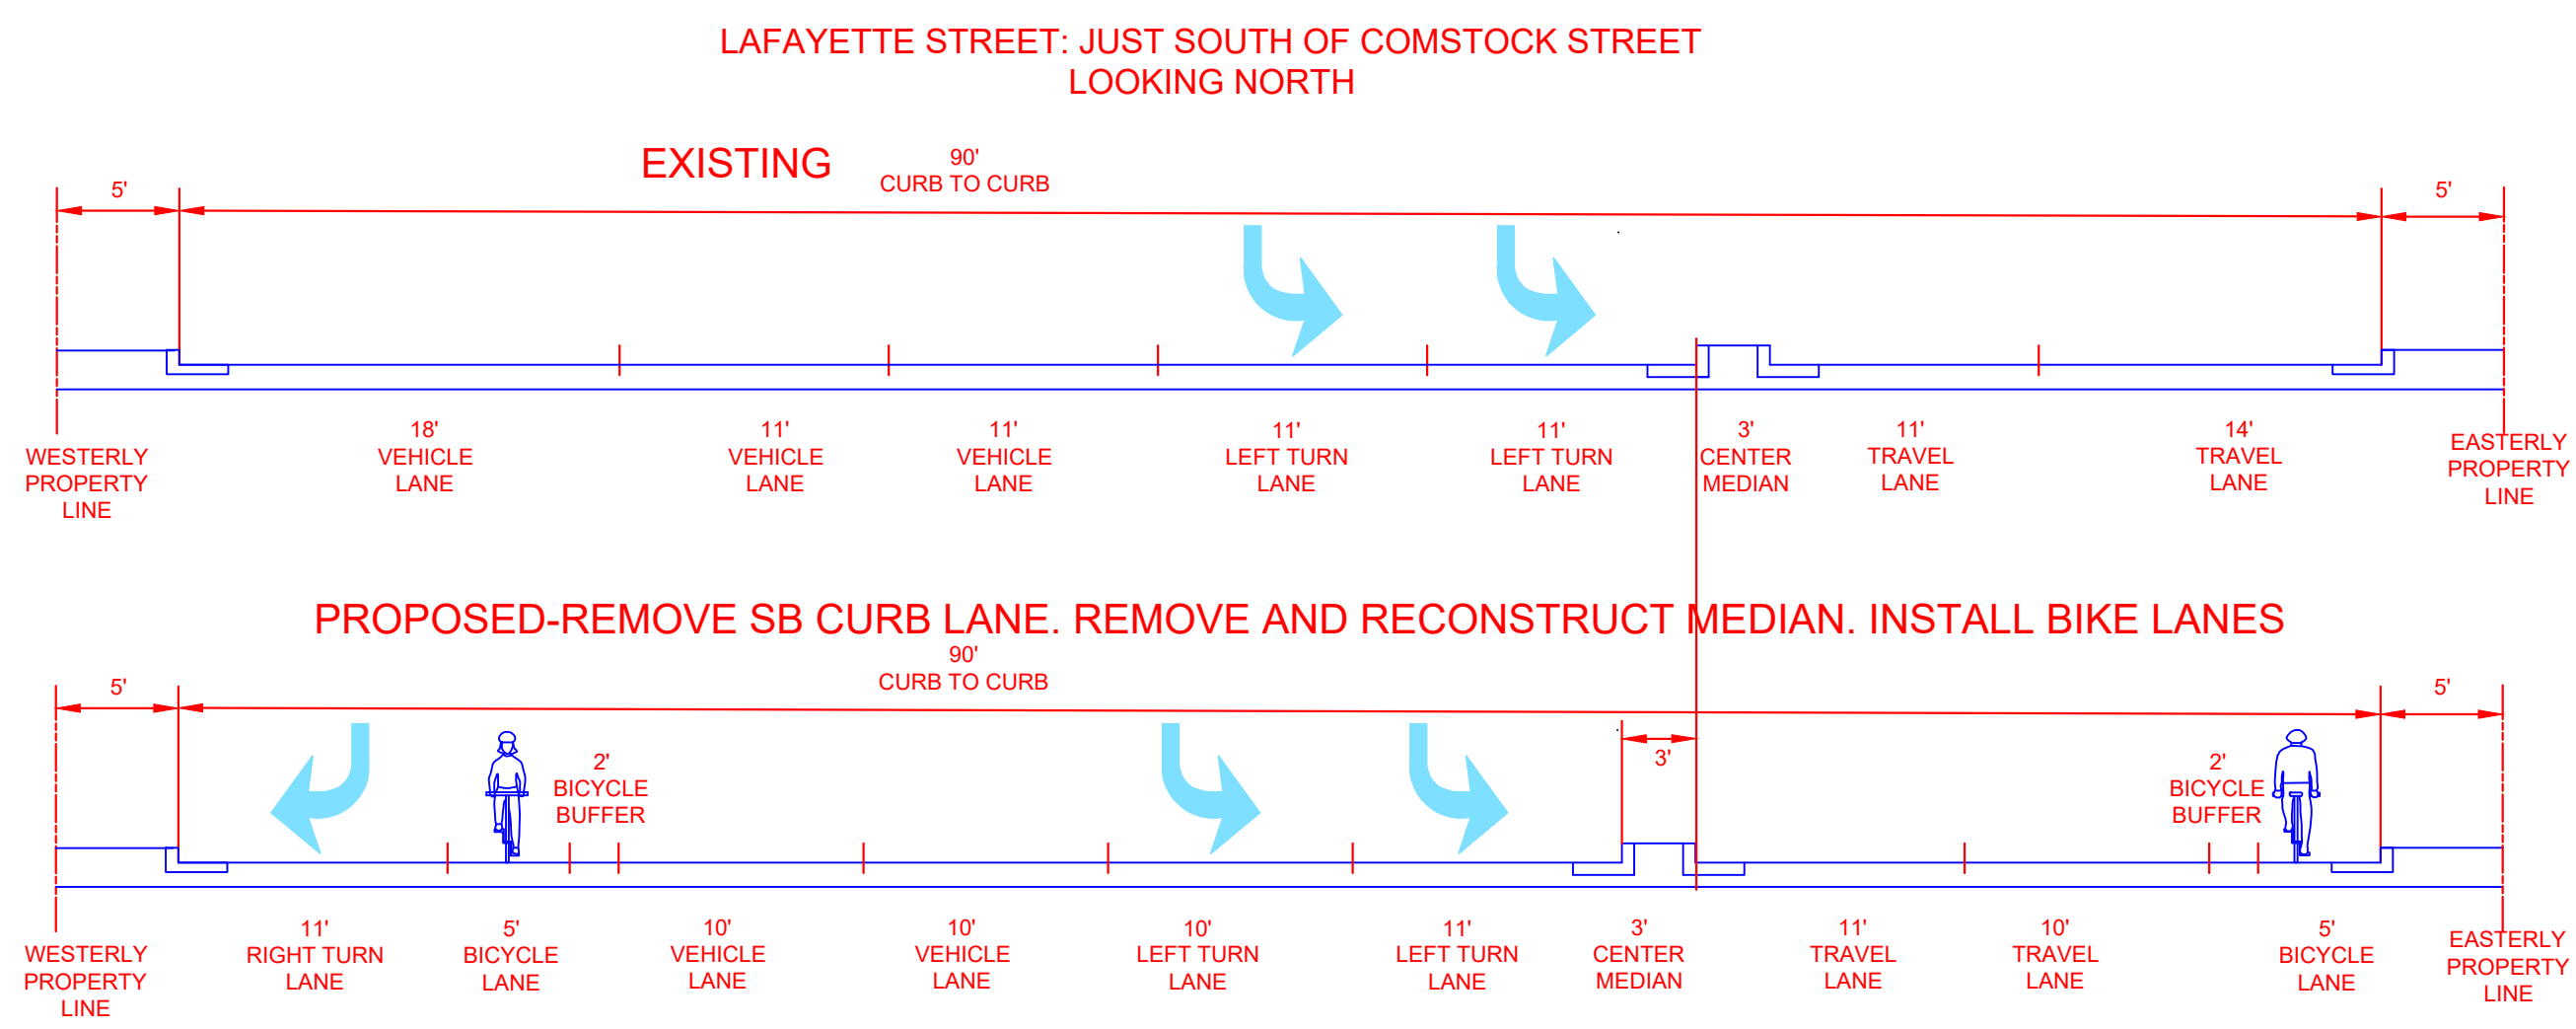

**35% PLANS
NOT FOR CONSTRUCTION**

PROJECT No. CE 02-XX-XX				CITY OF SANTA CLARA ENGINEERING DEPARTMENT				APPROVED BY							
ACCOUNT No. XXX-4443-8030-XXXX								TITLE							
DATE	No.	REVISION	BY	PROJECT TITLE				DATE	INITIAL	DATE	R.C.E. No.				
								DESIGNED BY	XX	XX/02	Survey No.				
								SHEET TITLE				DRAWN BY			TRACING No.
												CHECKED BY			11,XXX-D
								AS BUILT BY			SHEET 2 OF 5				

SEE SHEET 2

SEE UPPER RIGHT

SEE LOWER LEFT

SEE SHEET 4

2845 DWY


2805 DWY

OLD RR TRACKS

WALSH AVE

MARTIN AVE

LAFAYETTE STREET: CENTRAL EXPRESSWAY TO SHULMAN AVENUE LOOKING NORTH

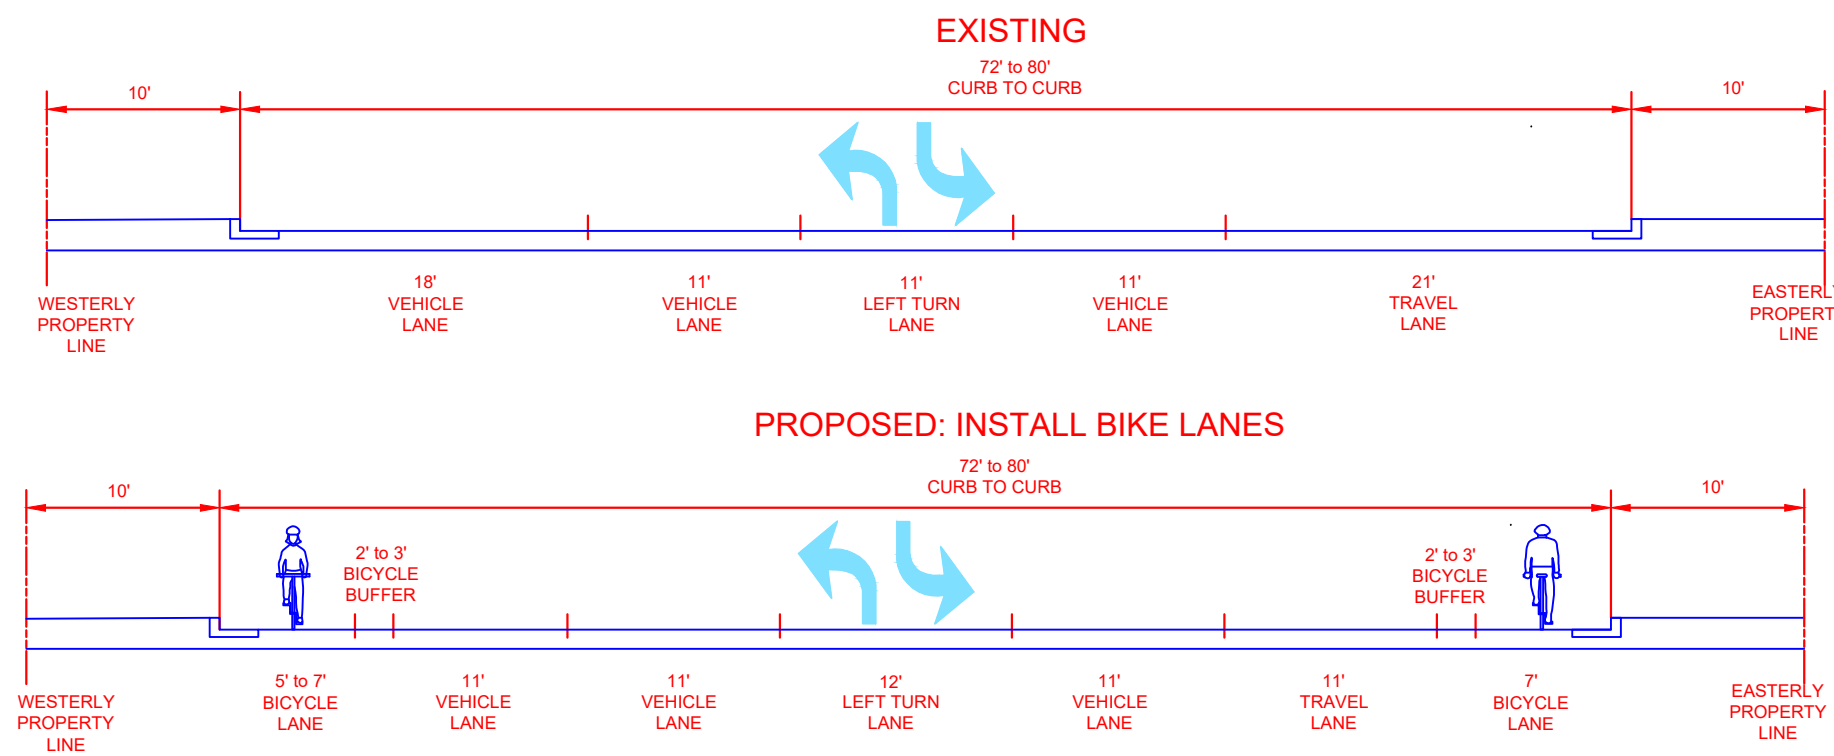

**35% PLANS
NOT FOR CONSTRUCTION**

PROJECT No. CE 02-XX-XX				CITY OF SANTA CLARA ENGINEERING DEPARTMENT				APPROVED BY			
ACCOUNT No. XXX-4443-8030-XXXX								TITLE			
DATE	No.	REVISION	BY	PROJECT TITLE				DATE	R.C.E. No.		
								DESIGNED BY	INITIAL	DATE	Survey No.
				SHEET TITLE				DRAWN BY	TRACING No.		
								CHECKED BY			11,XXX-D
								AS BUILT BY	SHEET 3 OF 5		

SEE SHEET 3

MARTIN AVE

80ft SHIFT TAPER
due to 3ft lane shift

TRANSITION TO 2ft
NB buffer

110ft SHIFT TAPER
due to 4ft lane shift

RICHARD AVE


SHULMAN AVE

MATHEW ST

MEMOREX DR

SEE SHEET 5

LAFAYETTE STREET:
CENTRAL EXPRESSWAY TO SHULMAN AVENUE
LOOKING NORTH

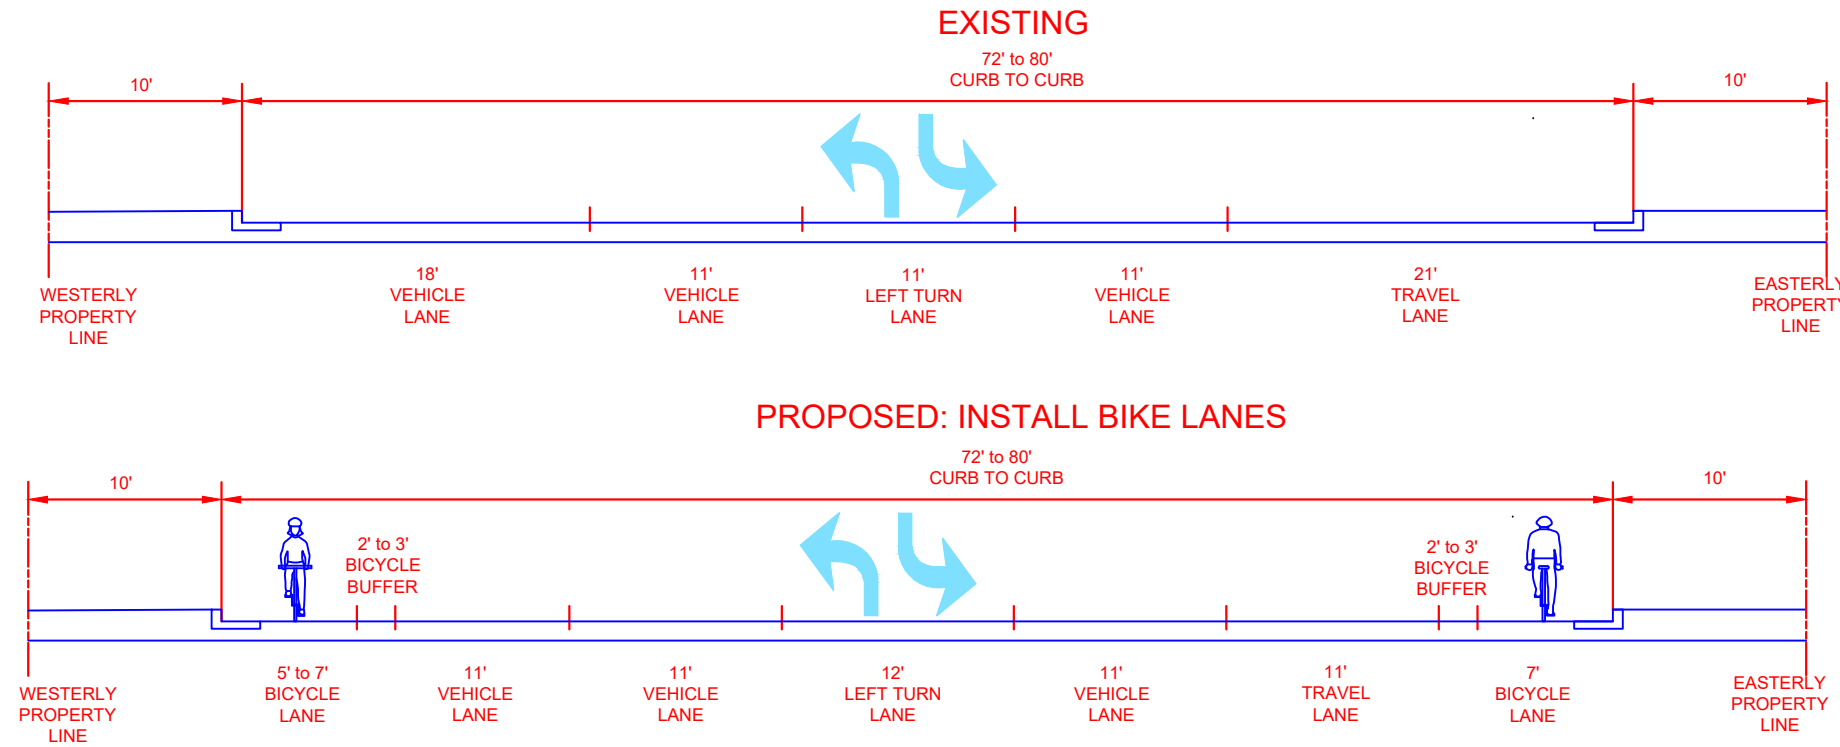



**35% PLANS
NOT FOR CONSTRUCTION**

PROJECT No. CE 02-XX-XX		APPROVED BY	
ACCOUNT No. XXX-4443-8030-XXXX		TITLE	
DATE	No.	REVISION	BY

CITY OF SANTA CLARA ENGINEERING DEPARTMENT	
PROJECT TITLE	
SHEET TITLE	

DATE	INITIAL	DATE	R.C.E. No.
DESIGNED BY	XX	XX/02	Survey No.
DRAWN BY			
CHECKED BY			
AS BUILT BY			
TRACING No. 11,XXX-D			SHEET 4 OF 5

**OPTION 1: COUNCIL APPROVES
REMOVAL OF PARKING**

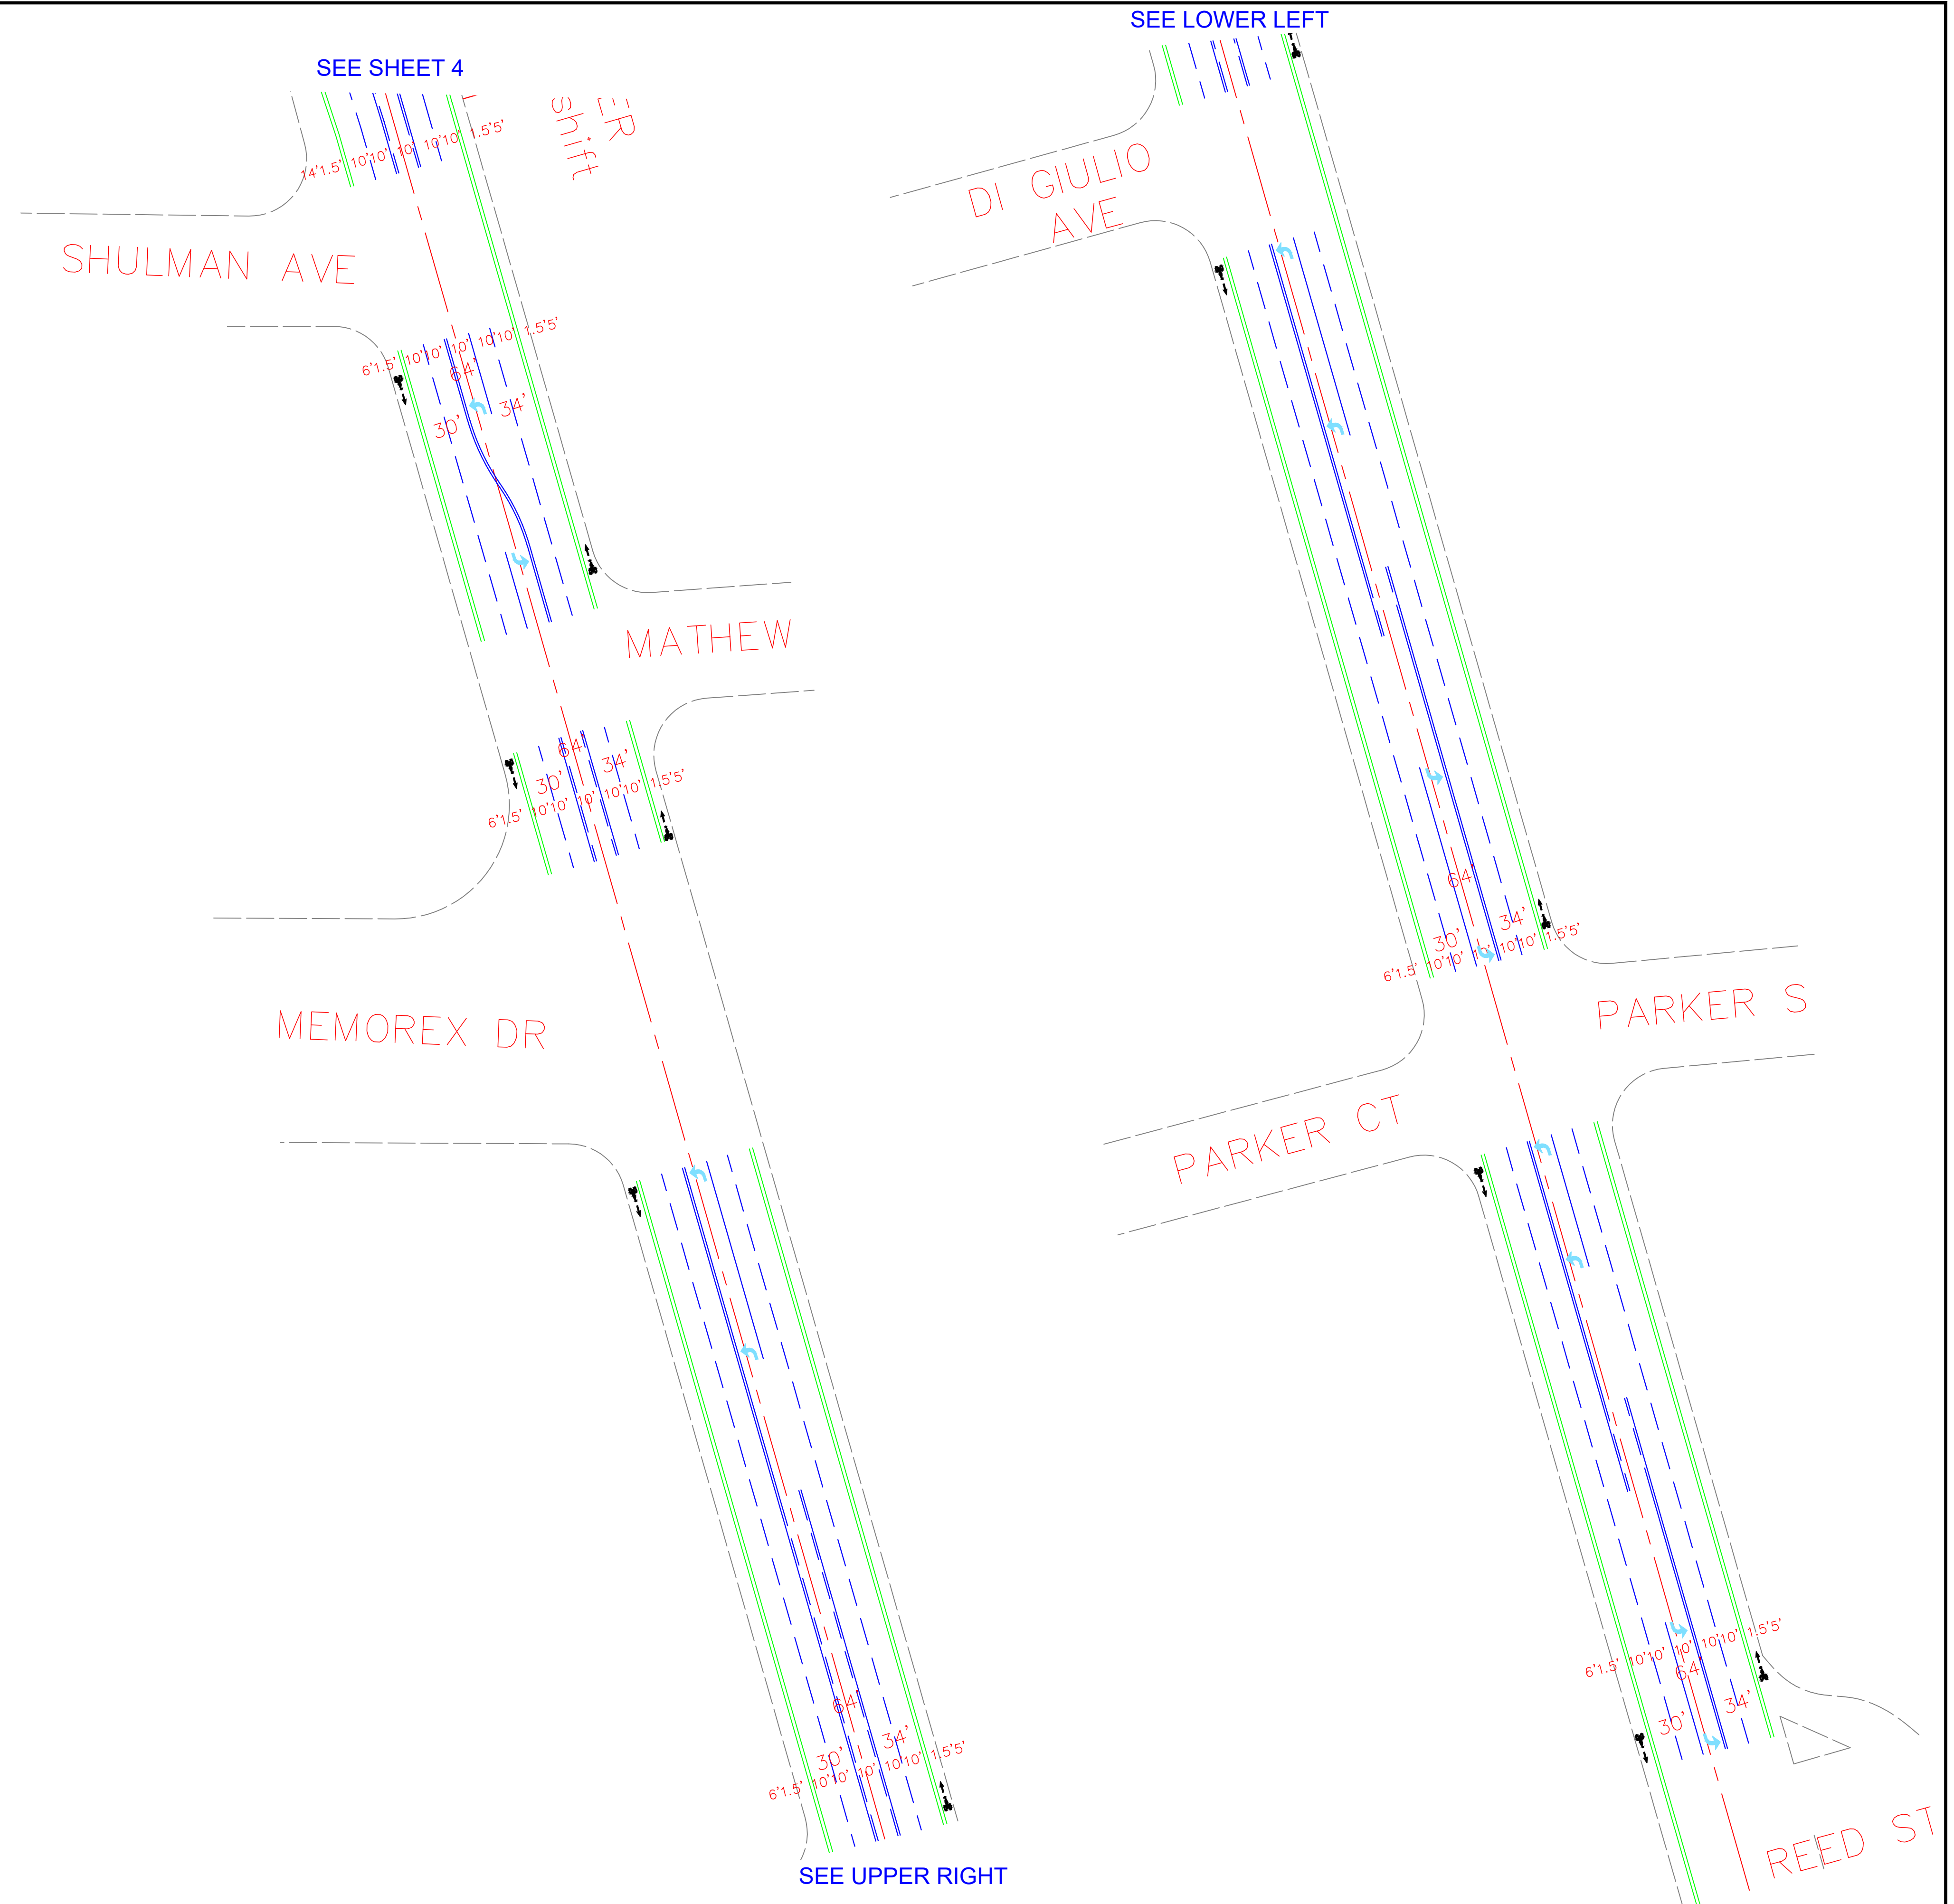
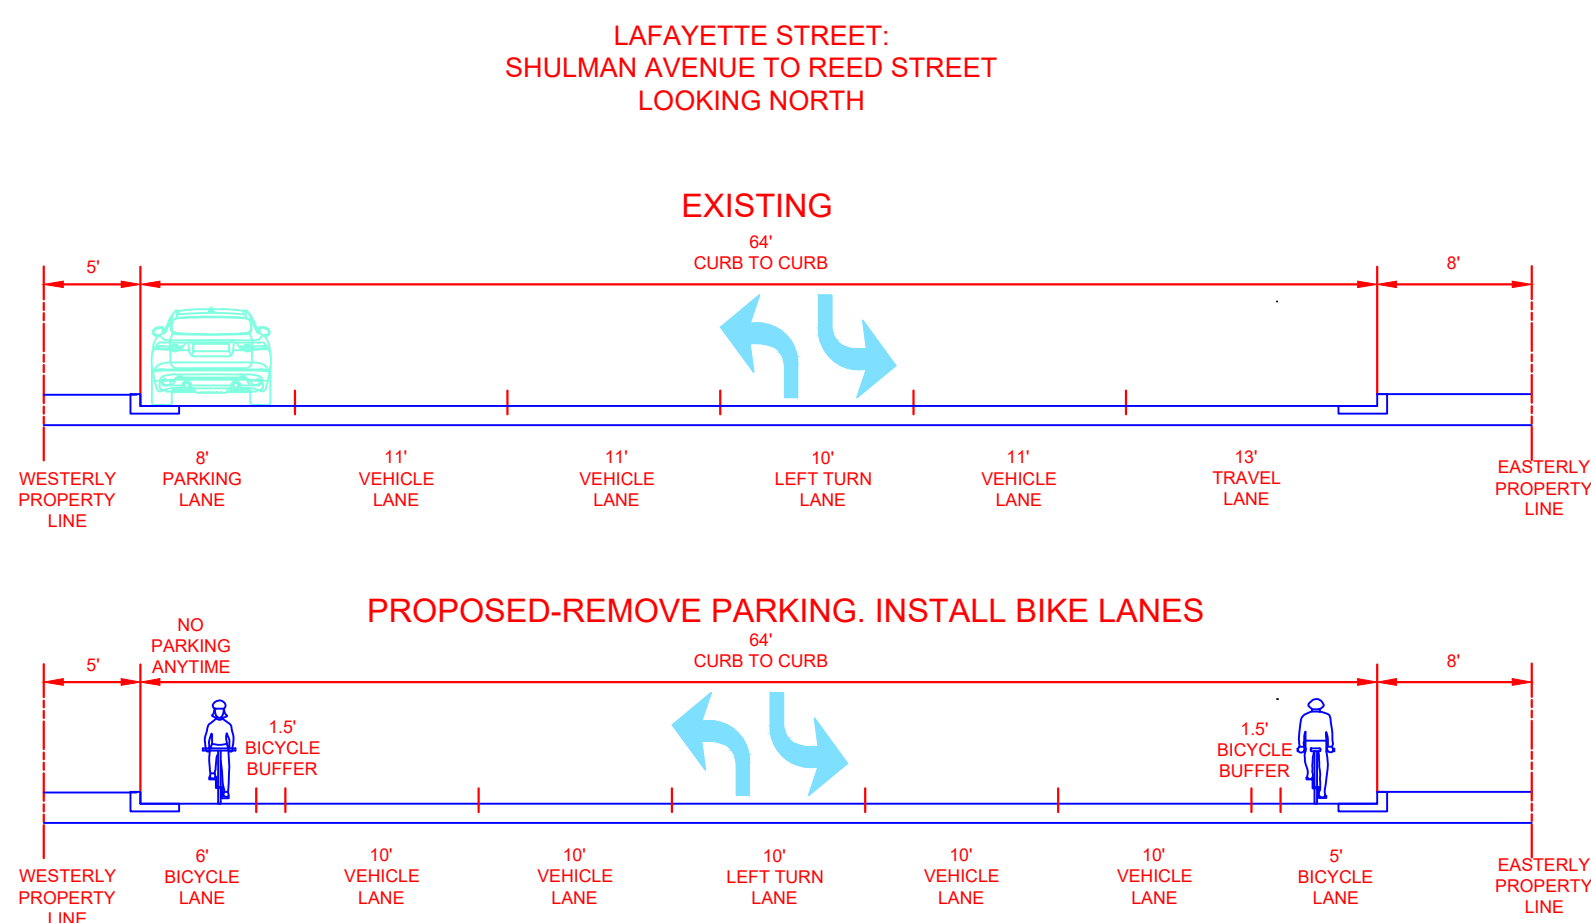


**35% PLANS
NOT FOR CONSTRUCTION**

PROJECT No. CE 02-XX-XX		CITY OF SANTA CLARA ENGINEERING DEPARTMENT		APPROVED BY	
ACCOUNT No. XXX-4443-8030-XXXX				TITLE	
DATE	No.	REVISION	BY	DATE	R.C.E. No.
				DESIGNED BY	Survey No.
				DRAWN BY	TRACING No.
				CHECKED BY	11,XXX-D
				AS BUILT BY	SHEET 5A OF 5

OPTION 2: COUNCIL DOES NOT APPROVE REMOVAL OF PARKING

OPTION 2A PREFERRED SINCE OPTION 2B CONTAINS BICYCLIST CONFLICTS WITH PARKED VEHICLE DOORS AND TRAVELING VEHICLES

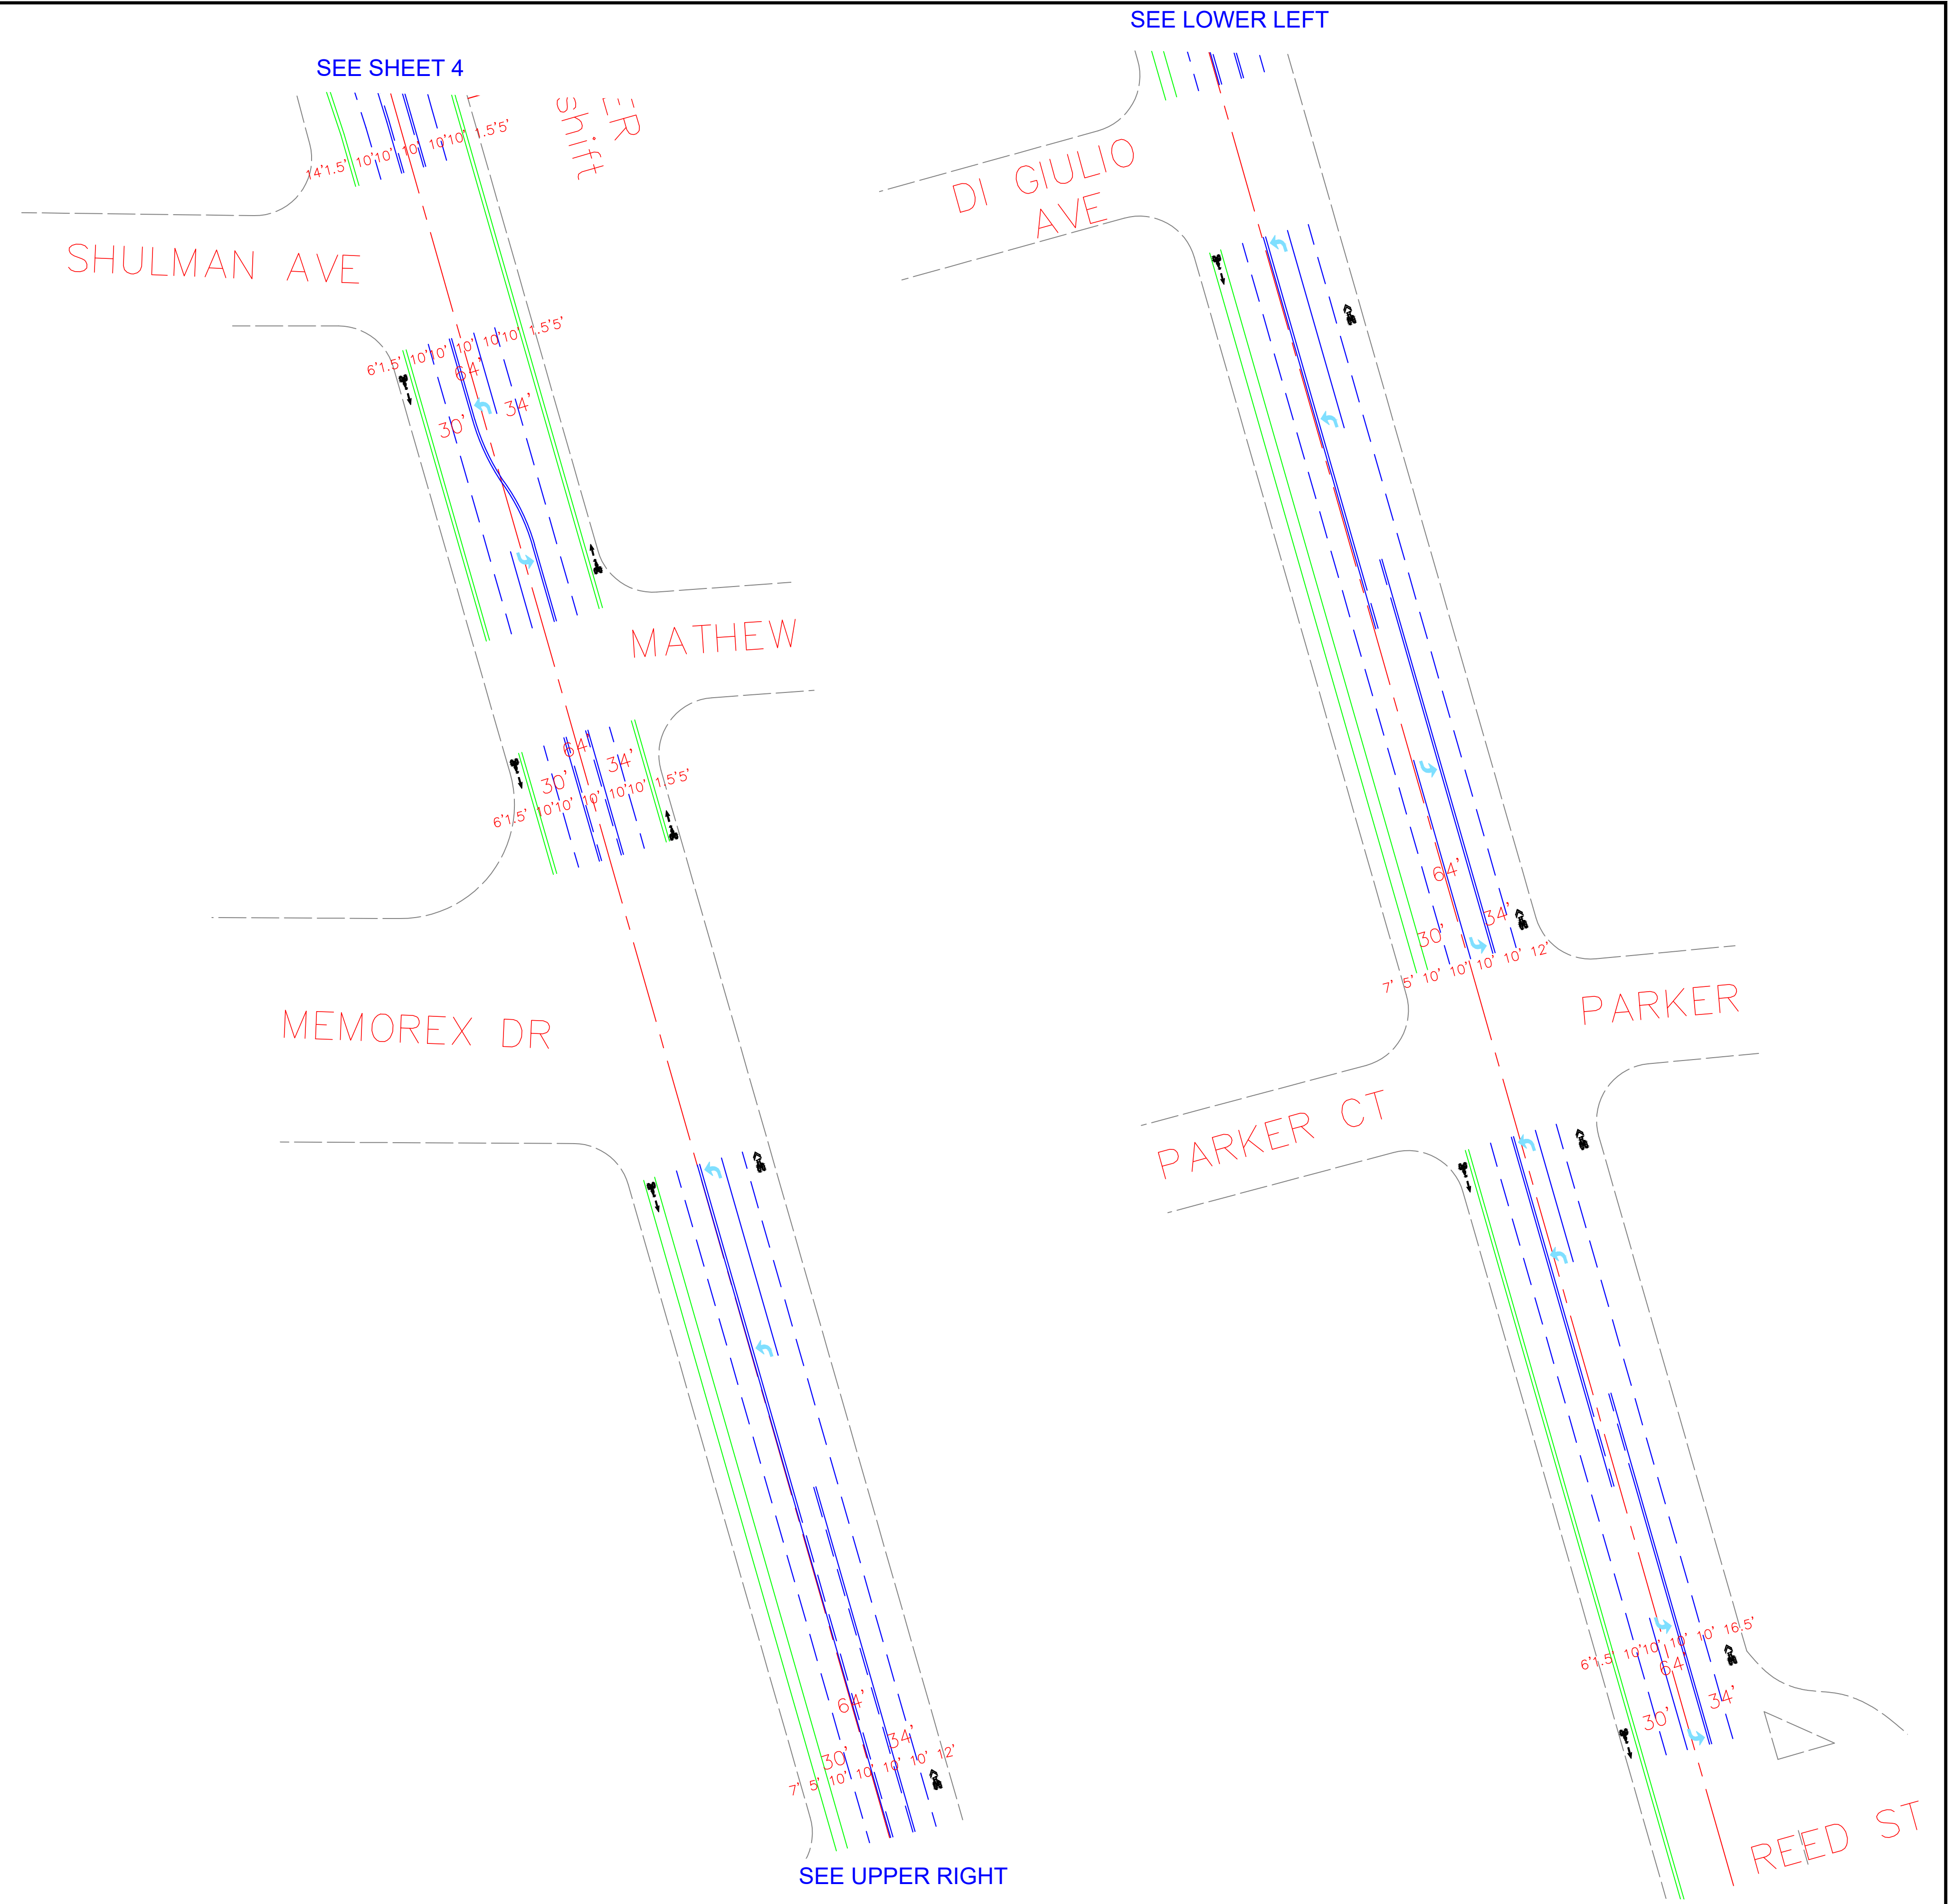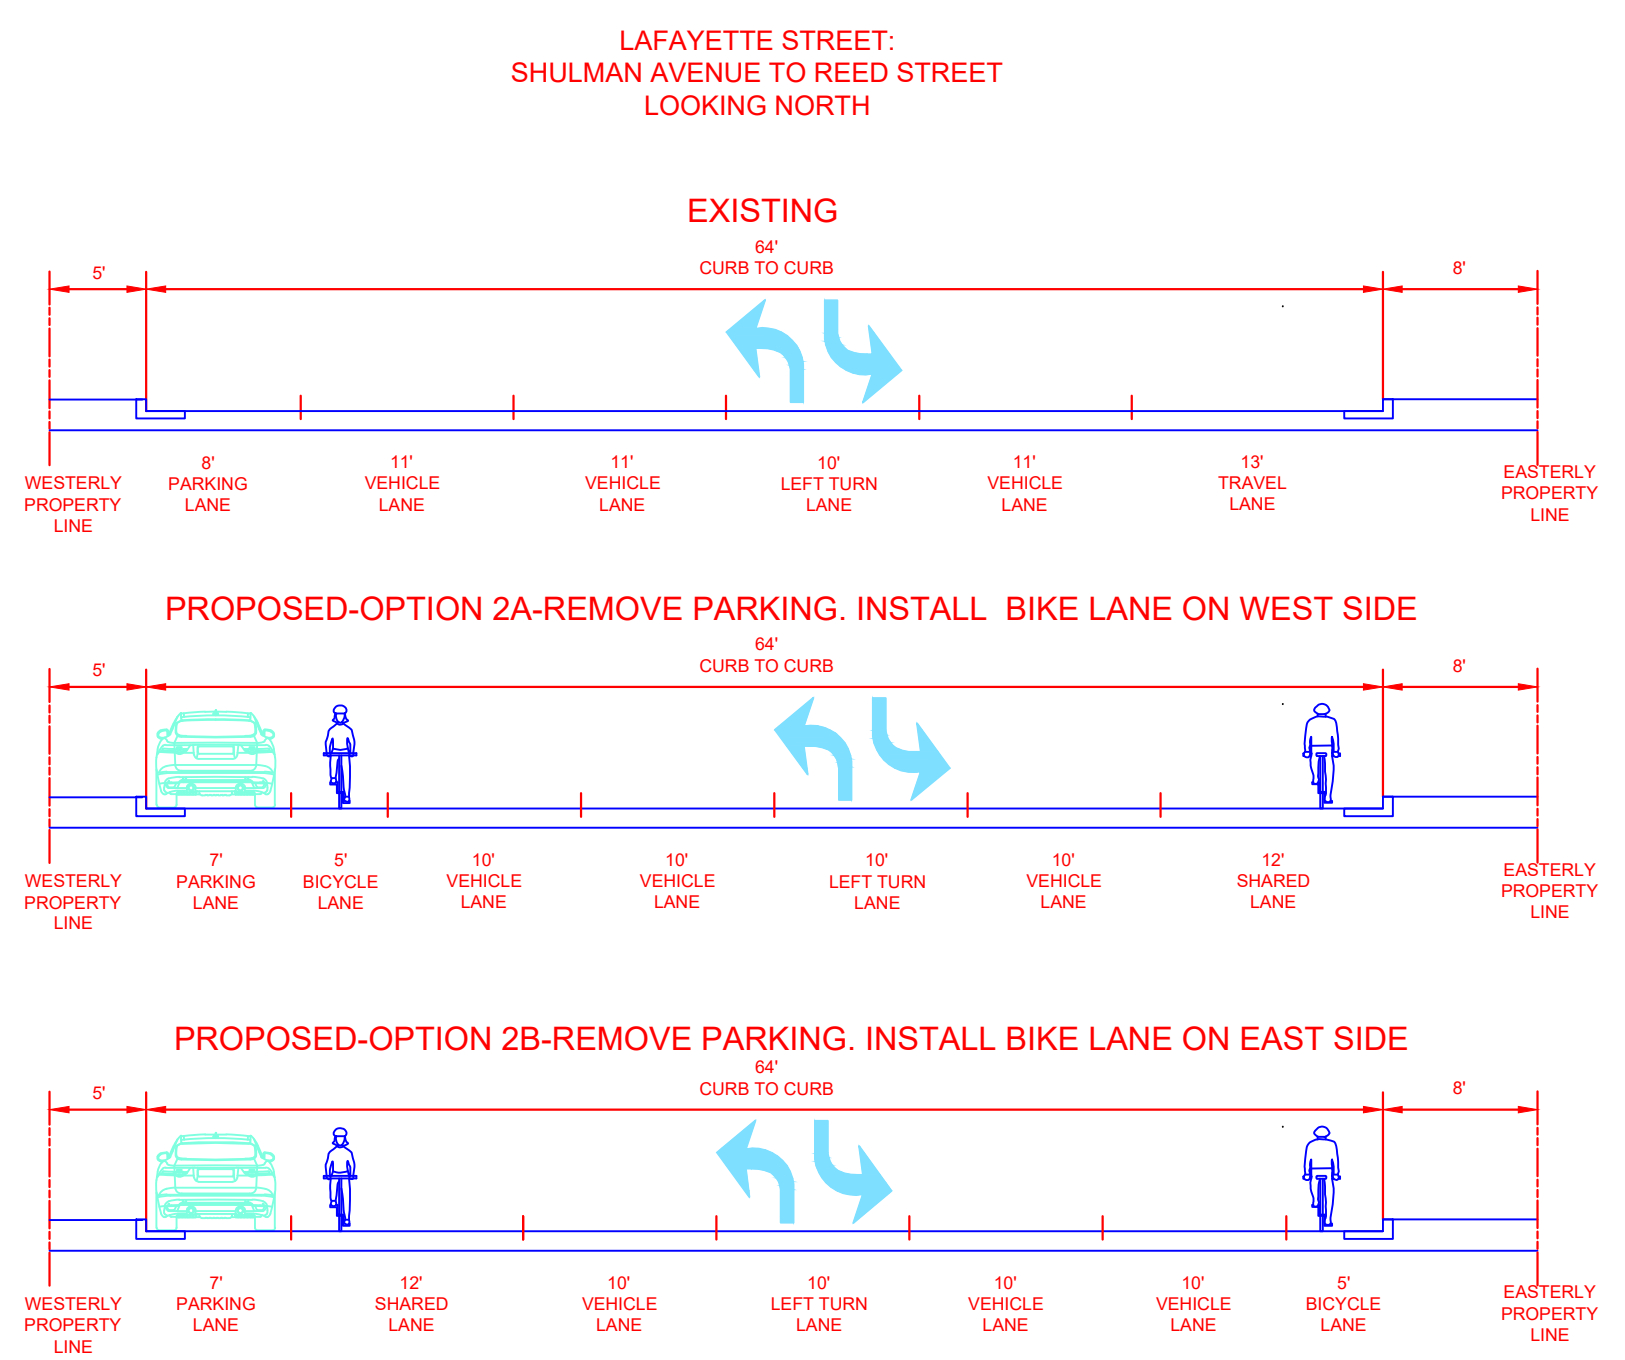

**35% PLANS
NOT FOR CONSTRUCTION**

PROJECT No. CE 02-XX-XX		CITY OF SANTA CLARA ENGINEERING DEPARTMENT		APPROVED BY	
ACCOUNT No. XXX-4443-8030-XXXX				TITLE	
DATE	No.	REVISION	BY	DATE	R.C.E. No.
				INITIAL	DATE
				DESIGNED BY	Survey No.
				DRAWN BY	TRACING No.
				CHECKED BY	11,XXX-D
				AS BUILT BY	SHEET 5B OF 5